

ANSALDO

Ansaldo Sistemi Industriali s.p.a.

COMMISSIONE - REQUISITION

377440013

CLIENTE - CUSTOMER

DANIELI AUTOMATION

SCHEMA - ELEMENTARY

FN2902970

IDENTIFICAZIONE - IDENTIFICATION

NF29029501

SEZIONE - SECTION

SEZ. 1

ANNO - YEAR

1999

5VC 100MYAR 33KV

THYRISTOR VALVE

-G01

=90E9120.01.G1

THYRISTOR VALVE

ANSALDO

Ansaldo Sistemi Industriali s.p.a.

COMMISSIONE - REQUISITION 377440013

CLIENTE - CUSTOMER DANIELI AUTOMATION

SCHEMA - ELEMENTARY FN290297C

IDENTIFICAZIONE - IDENTIFICATION NF29029501

SEZIONE - SECTION SEZ. 1 ANNO - YEAR 1999



SVC 180MVAR 33KV


THYRISTOR VALVE

-G01

=90E9

THYR

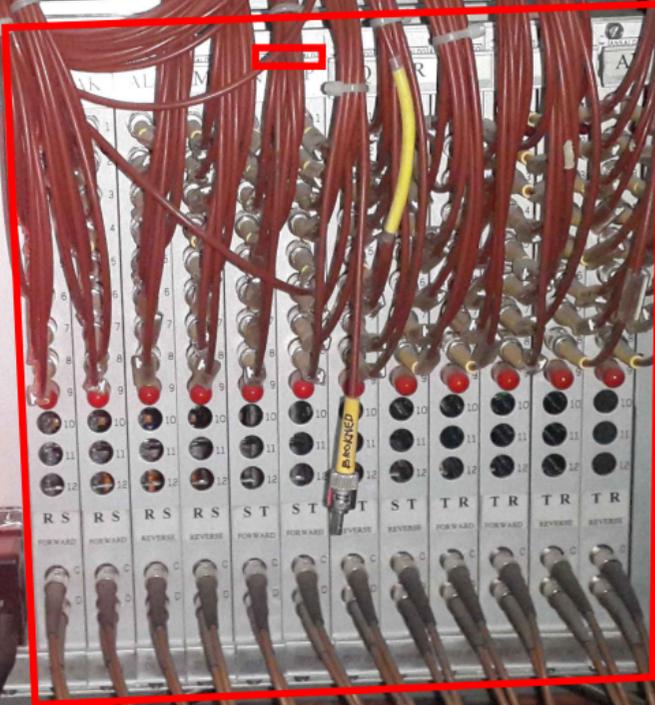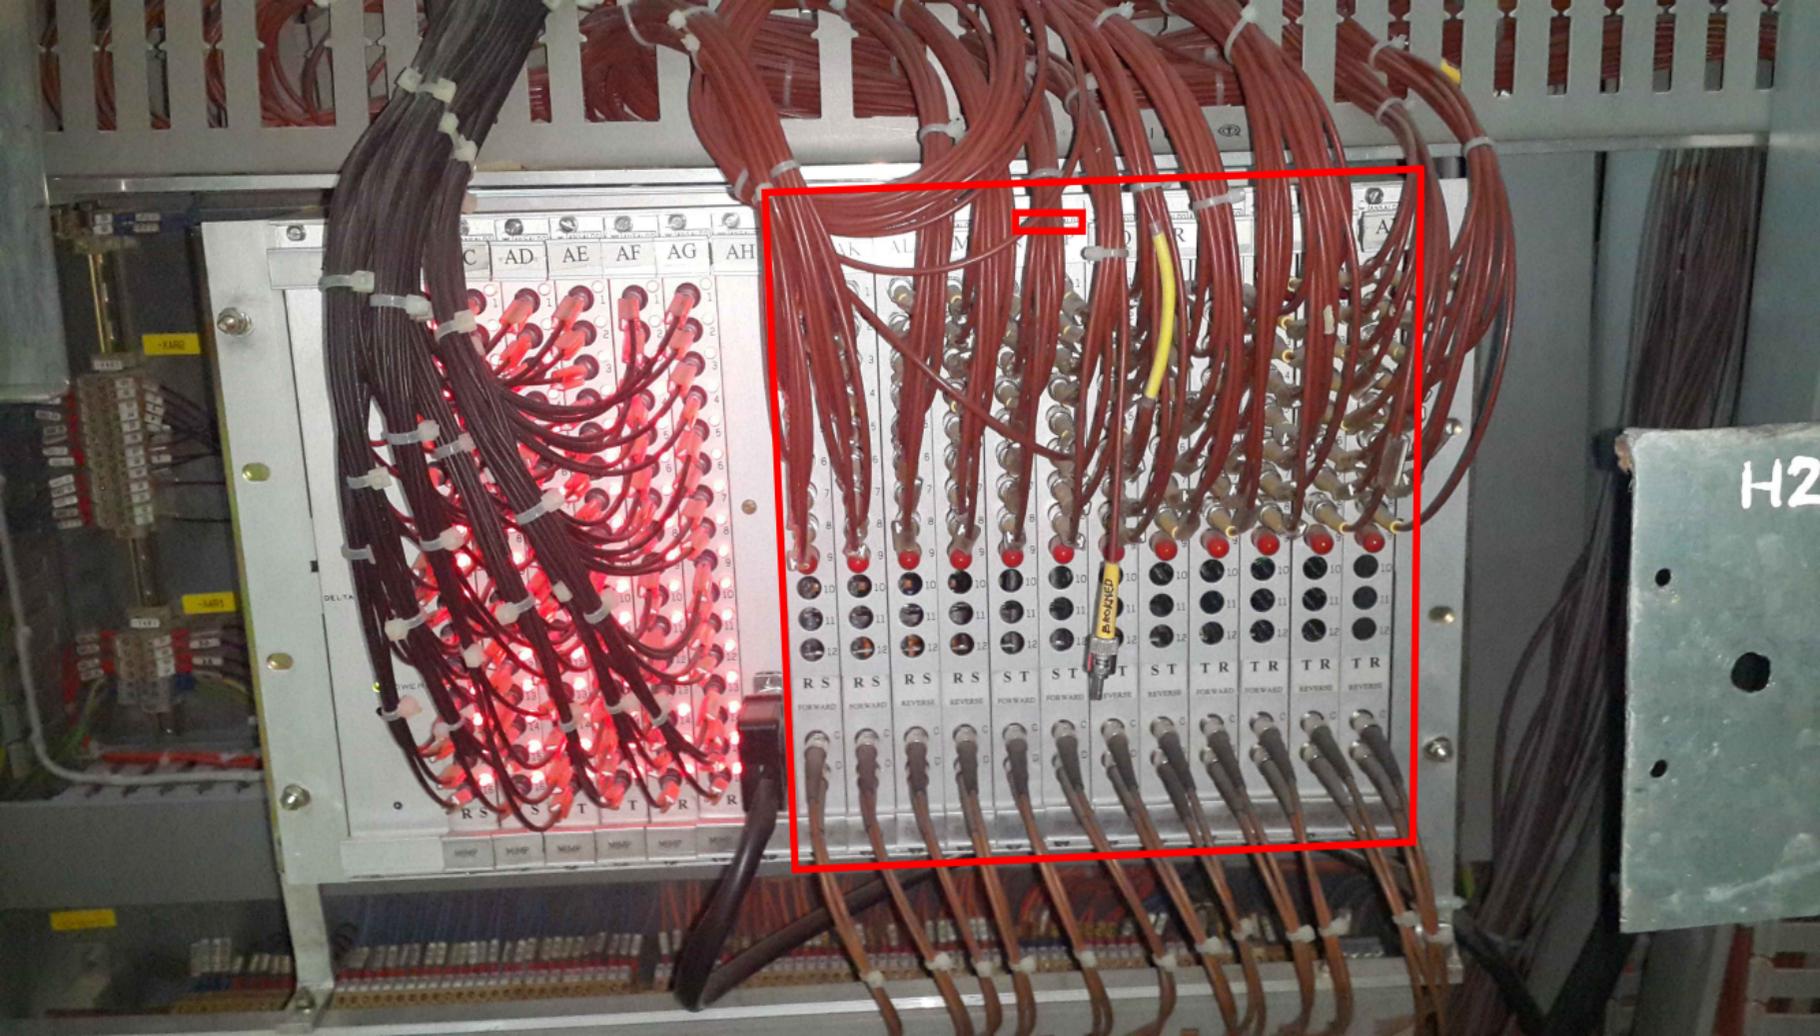

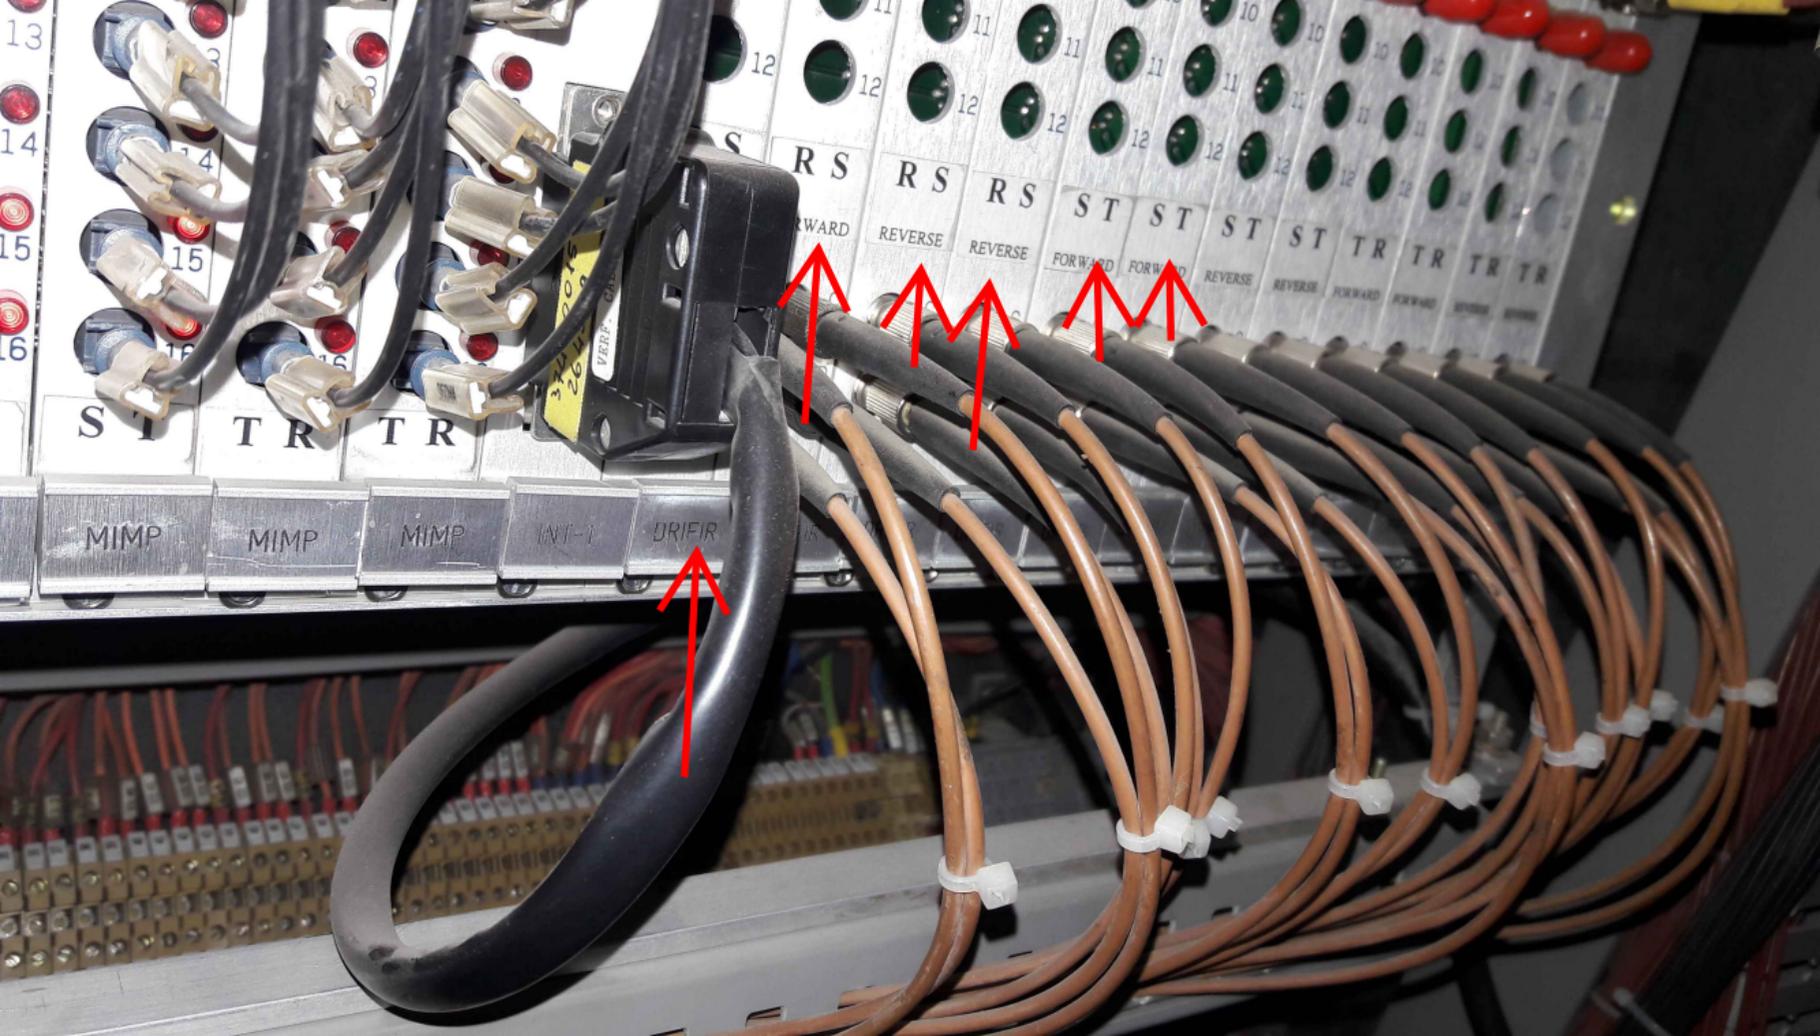

MIMP

MIMP

MIMP

INT-1

DRIFR

FORWARD

REVERSE

REVERSE

FORWARD

FORWARD

REVERSE

REVERSE

FORWARD

FORWARD

REVERSE

REVERSE

FORWARD

13

14

15

16

12

12

ST

TR

TR

RS

RS

RS

ST

ST

ST

ST

TR

TR

TR

320 2016
2600

This document is subject to DANIELI & C. right of ownership and cannot be reproduced



ESFAHAN STEEL COMPANY - SABA EXPANSION PROJECT



DANIELI UNITED







Rev.	Date	Issue description	Compiled	Checked	Approved
00	25 th September 00	First Issue	MUM/DU	M. Mattucci	P. Franco

CAD
THIS DRAWING IS PROPERTY OF ANSALDO AND MAY NOT BE REPRODUCED OR RELEASED TO THIRD PARTIES WITHOUT WRITTEN AUTHORISATION



C. 3740015
Revision
FN290297C
Dwg number

ANSALDO
Ansaldo Sistemi Industrial s.p.a.

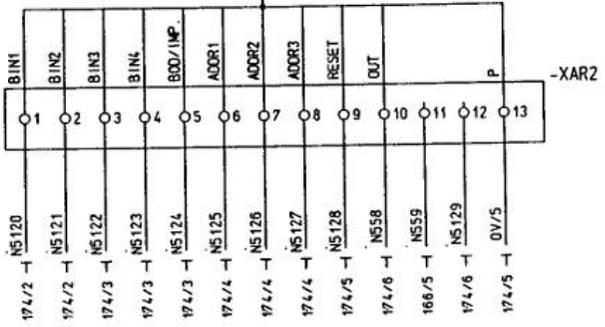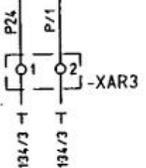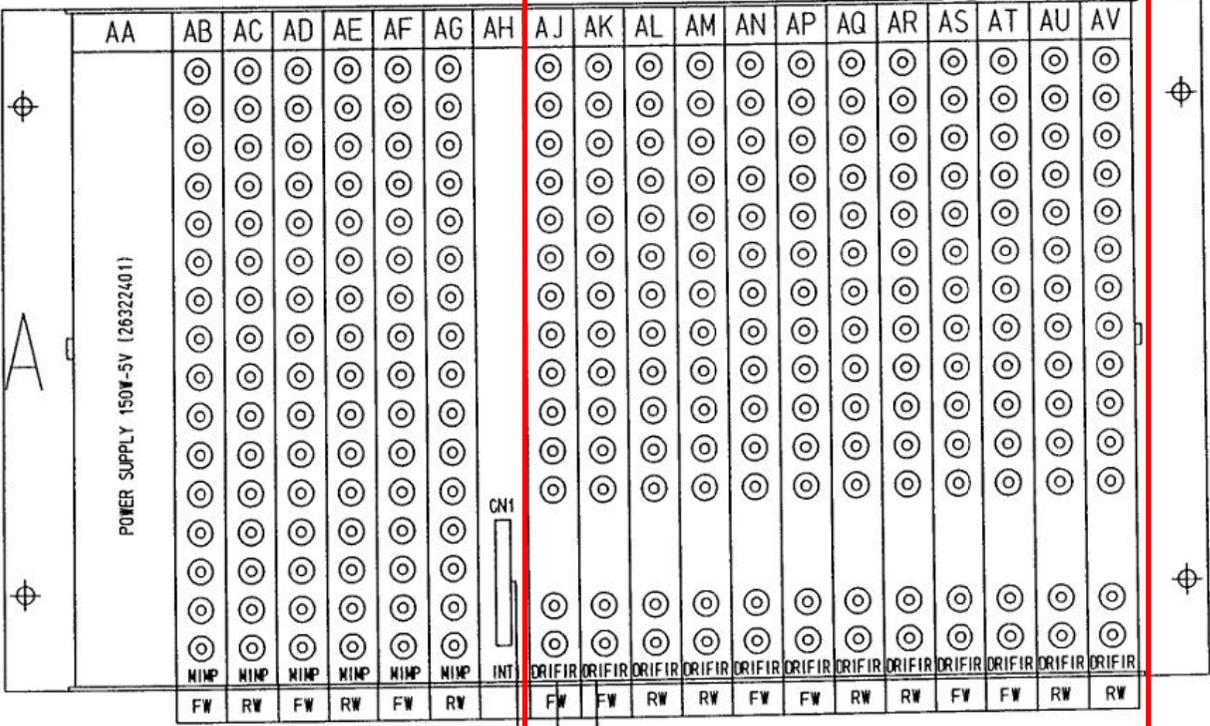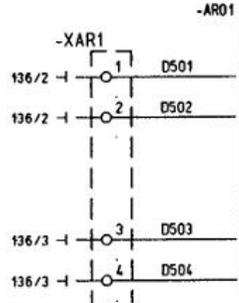

02	AS BUILT	25-09-03	MARIANI	DESIGN	ESPOSITO
01	AFTER TESTING	15-12-99	EMPRIO	CHECK	PERNA
	REVISION	DATE	NAME	STAND	IEC




ESFAHAN STEEL COMPANY-SABA EXPANSION PROJECT
Dwg number
Revision
02



TITLE
FIRING / MONITORING

180 NVAR SVC SMF1	=90E9120.06	=U5	SH. 250
	-A01		M.SH. 252
JOB N. 2155	DRAWING N. SM1 ED 90E9120 4.21	REV. 02	TOT.

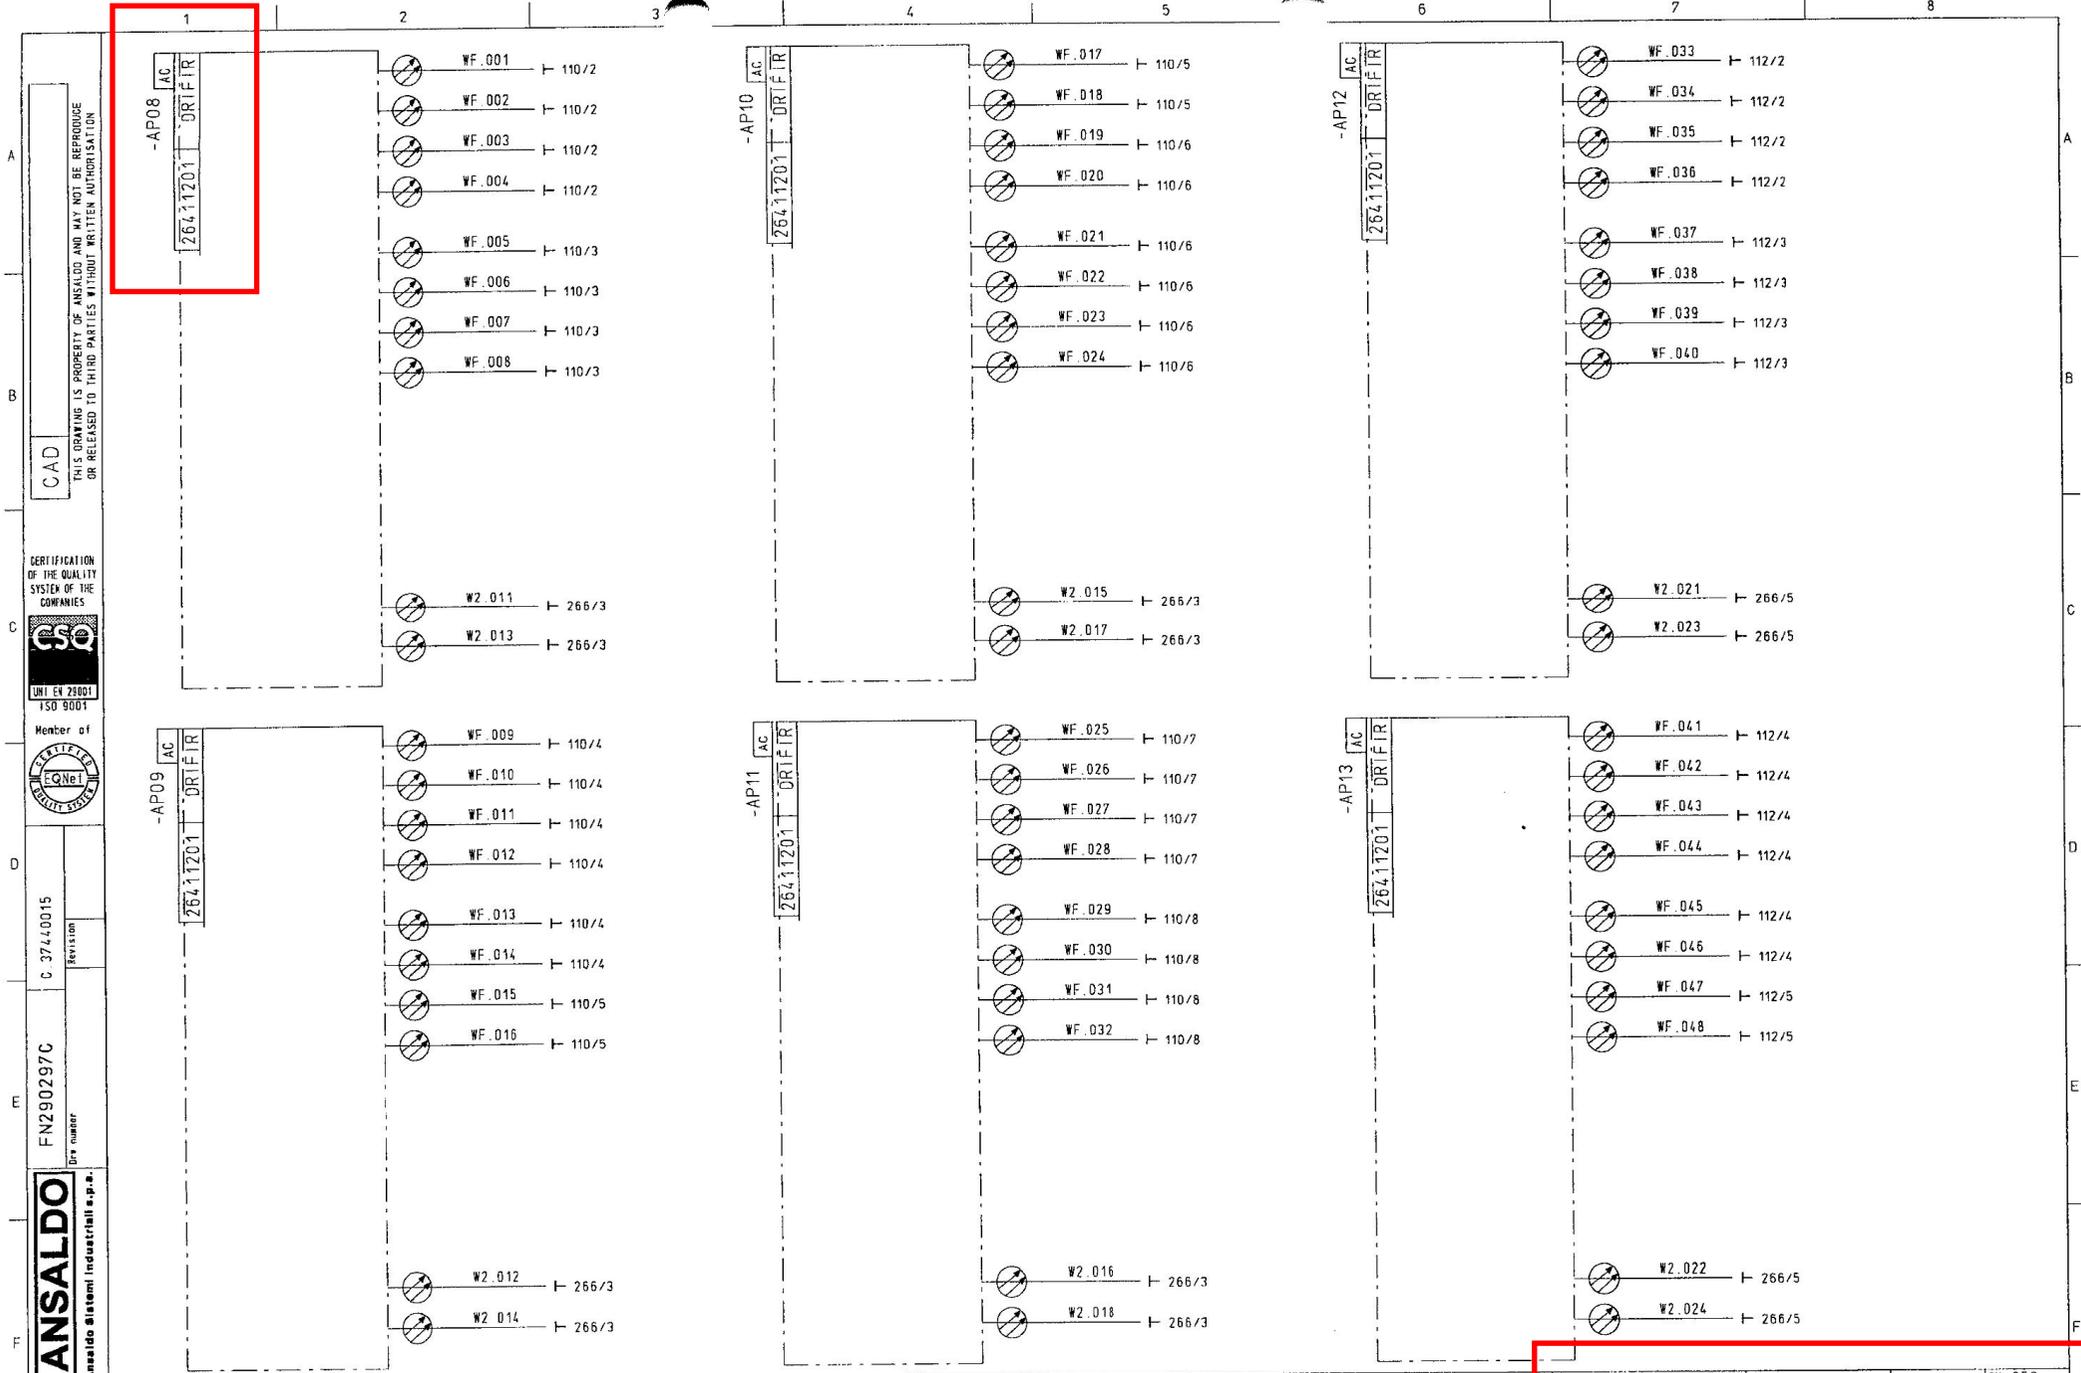

CAD
THIS DRAWING IS PROPERTY OF ANSALDO AND MAY NOT BE REPRODUCED OR RELEASED TO THIRD PARTIES WITHOUT WRITTEN AUTHORIZATION

CERTIFICATION OF THE QUALITY SYSTEM OF THE COMPANIES
UNI EN 29001 ISO 9001

Member of
GRNet

C 374.0015
Revision

FN290297C
Dwg number

ANSALDO
Ansaldo Sistemi Industriali s.p.a.

- WF.001 T 110/2
- WF.002 T 110/2
- WF.003 T 110/2
- WF.004 T 110/2
- WF.005 T 110/3
- WF.006 T 110/3
- WF.007 T 110/3
- WF.008 T 110/3

- W2.011 T 266/3
- W2.013 T 266/3

- WF.009 T 110/4
- WF.010 T 110/4
- WF.011 T 110/4
- WF.012 T 110/4
- WF.013 T 110/4
- WF.014 T 110/4
- WF.015 T 110/5
- WF.016 T 110/5

- W2.012 T 266/3
- W2.014 T 266/3

- WF.017 T 110/5
- WF.018 T 110/5
- WF.019 T 110/6
- WF.020 T 110/6
- WF.021 T 110/6
- WF.022 T 110/6
- WF.023 T 110/6
- WF.024 T 110/6

- W2.015 T 266/3
- W2.017 T 266/3

- WF.025 T 110/7
- WF.026 T 110/7
- WF.027 T 110/7
- WF.028 T 110/7
- WF.029 T 110/8
- WF.030 T 110/8
- WF.031 T 110/8
- WF.032 T 110/8

- W2.016 T 266/3
- W2.018 T 266/3

- WF.033 T 112/2
- WF.034 T 112/2
- WF.035 T 112/2
- WF.036 T 112/2
- WF.037 T 112/3
- WF.038 T 112/3
- WF.039 T 112/3
- WF.040 T 112/3

- W2.021 T 266/5
- W2.023 T 266/5

- WF.041 T 112/4
- WF.042 T 112/4
- WF.043 T 112/4
- WF.044 T 112/4
- WF.045 T 112/4
- WF.046 T 112/4
- WF.047 T 112/5
- WF.048 T 112/5

- W2.022 T 266/5
- W2.024 T 266/5

01		AFTER TESTING	15-12-99	EMPIRID	CHECK	DATE	NAME	DATE	DESIGN	ESPOSITO	Revision	01	ESFAHAN STEEL COMPANY-SABA EXPANSION PROJECT		DANIELI AUTOMATION		TITLE FIRING OPTICAL FIBER		180 MVAR SVC SMF1		90E9120.06		=U5		SH 256	
01		REVISION	DATE	NAME	STAND	DATE	NAME	DATE	DESIGN	PERNA	Revision	01	Dwg number		DANIELI AUTOMATION		TITLE FIRING OPTICAL FIBER		JOB N.		DRAWING N.		REV.		TOT.	
																			2155		SM1 ED 90E9120 421		01		M SH. 258	